


30

HUDSON STREET
JERSEY CITY

10TH FLOOR AS-BUILT FLOOR PLAN

36,645 RSF

PERIMETER LARGE OFFICES	4
INTERIOR OFFICES	23
WORKSTATIONS	240
TOTAL CAPACITY	267
CONFERENCE ROOMS	4
COPY ROOMS	2

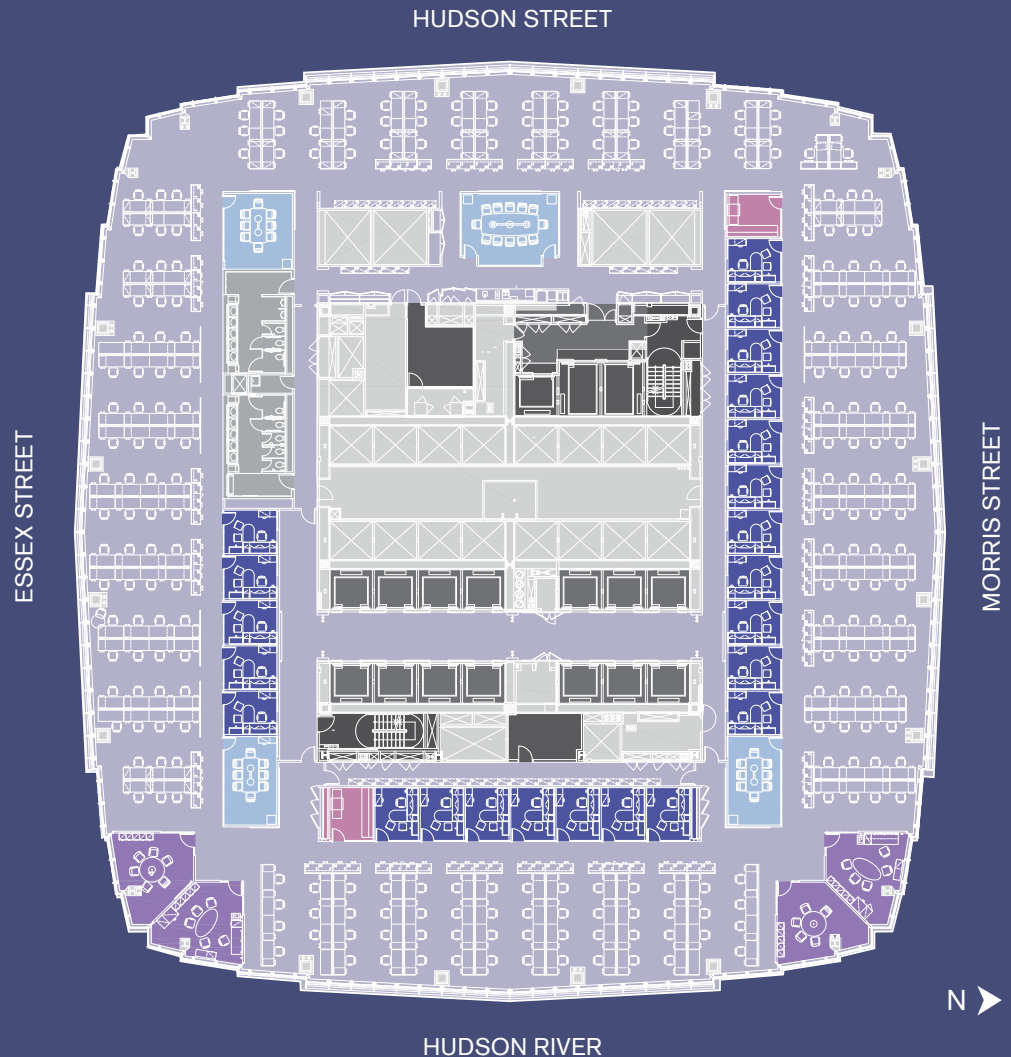

Hope G. Brodsky
Hope.Brodsky@nmrk.com
201.460.5110

Harrison Russell
Harrison.Russell@nmrk.com
201.504.5171

Hal Stein
Hal.Stein@nmrk.com
212.233.8185

Neil J. Goldmacher
Neil.Goldmacher@nmrk.com
212.372.2153

NEWMARK

No warranty or representation, express or implied, is made as to the accuracy of the information contained herein, and same is submitted subject to errors omissions, change of price, rental or other conditions, withdrawal without notice, and to any specific listing conditions, imposed by our principals.