


30

HUDSON STREET
JERSEY CITY

35TH FLOOR AS-BUILT FLOOR PLAN

37,206 RSF

INTERIOR OFFICES	21
CONFERENCE CENTERS	
INTERIOR CONFERENCE ROOMS	2
COPY ROOMS	1

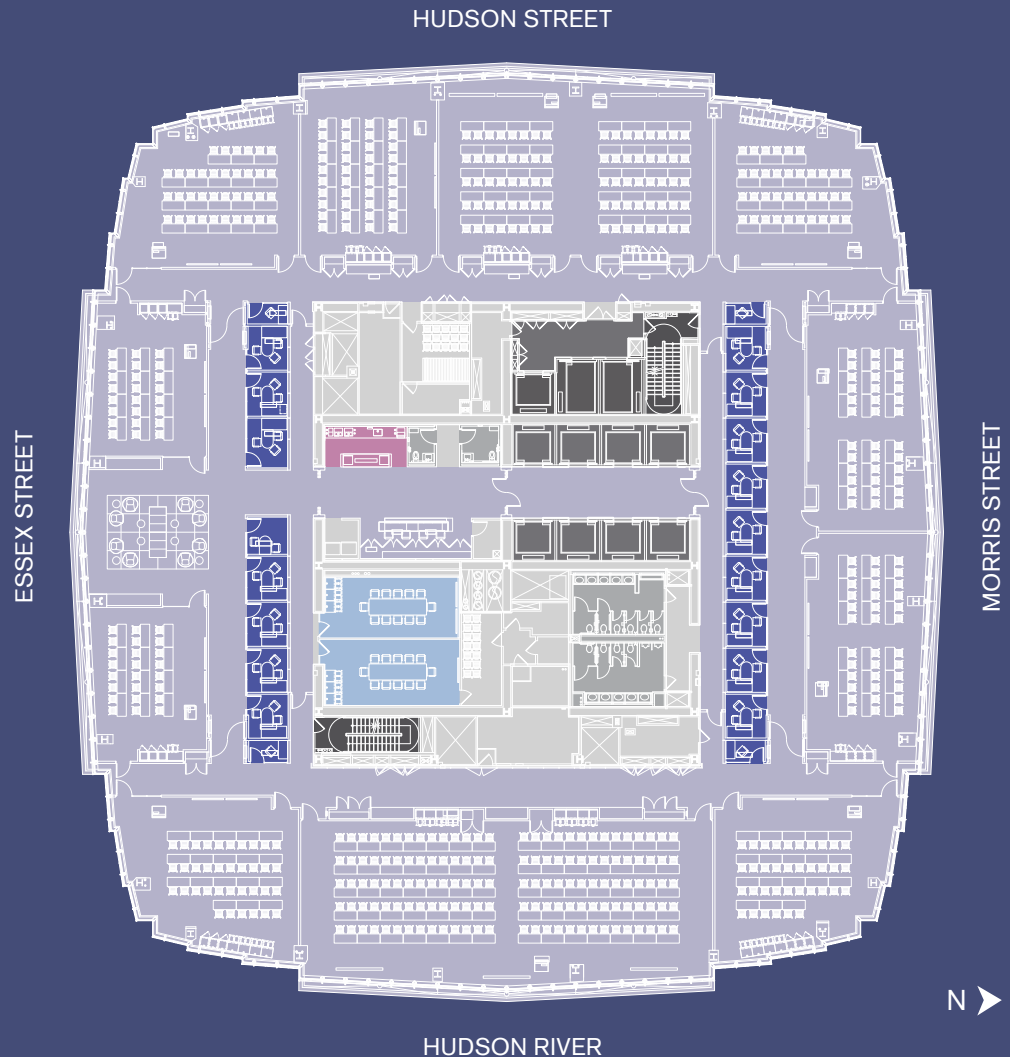

Hope G. Brodsky
Hope.Brodsky@nmrk.com
201.460.5110

Harrison Russell
Harrison.Russell@nmrk.com
201.504.5171

Hal Stein
Hal.Stein@nmrk.com
212.233.8185

Neil J. Goldmacher
Neil.Goldmacher@nmrk.com
212.372.2153

NEWMARK

No warranty or representation, express or implied, is made as to the accuracy of the information contained herein, and same is submitted subject to errors omissions, change of price, rental or other conditions, withdrawal without notice, and to any specific listing conditions, imposed by our principals.