


# 30

HUDSON STREET  
JERSEY CITY

## 4TH FLOOR AS-BUILT FLOOR PLAN

63,717 RSF

PERIMETER OFFICES	8
INTERIOR OFFICES	20
WORKSTATIONS	450
<b>TOTAL CAPACITY</b>	<b>478</b>
<hr/>	
CONFERENCE ROOMS	5
COPY ROOMS	2

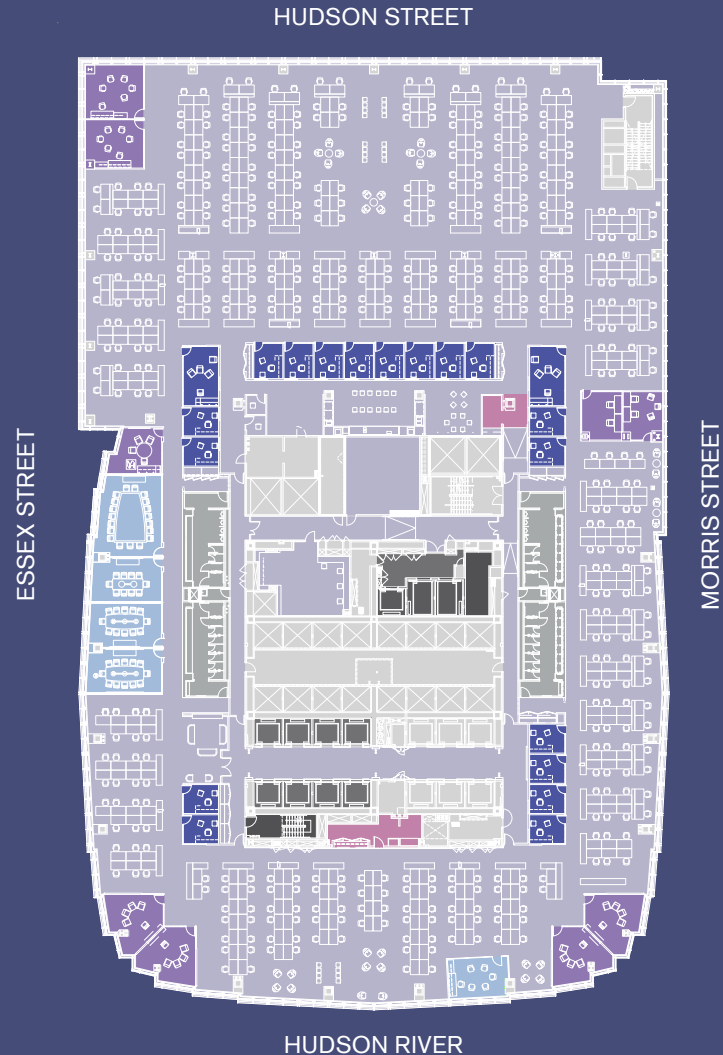

**Hope G. Brodsky**  
Hope.Brodsky@nrmk.com  
201.460.5110

**Harrison Russell**  
Harrison.Russell@nrmk.com  
201.504.5171

**Hal Stein**  
Hal.Stein@nrmk.com  
212.233.8185

**Neil J. Goldmacher**  
Neil.Goldmacher@nrmk.com  
212.372.2153

# NEWMARK

No warranty or representation, express or implied, is made as to the accuracy of the information contained herein, and same is submitted subject to errors omissions, change of price, rental or other conditions, withdrawal without notice, and to any specific listing conditions, imposed by our principals.