


# 30

HUDSON STREET  
JERSEY CITY

## 6TH FLOOR AS-BUILT FLOORPLAN (CURRENTLY AUDITORIUM)

### 63,926 RSF

WORKSTATIONS	314
TOTAL CAP	314
CONFERENCE ROOMS	7
AUDITORIUM	597

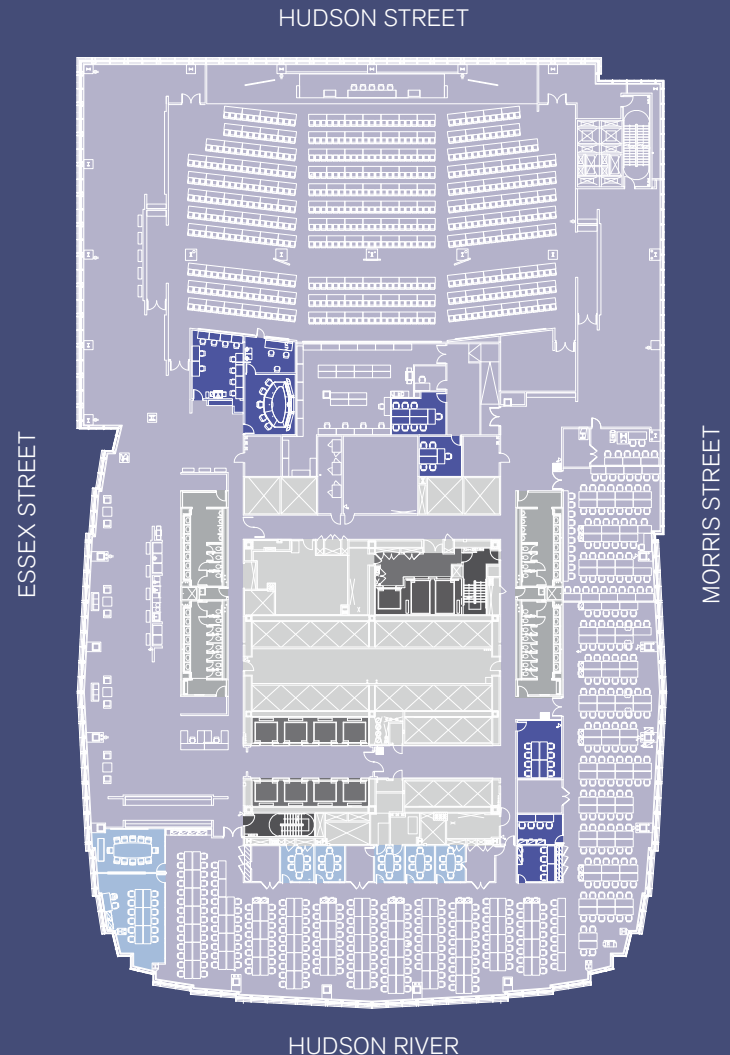

**Hope G. Brodsky**  
hbrodsky@ngkf.com  
201.460.5110

**Harrison Russell**  
hrussell@ngkf.com  
201.504.5171

**Hal Stein**  
hstein@ngkf.com  
212.233.8185

**Neil J. Goldmacher**  
ngoldmacher@ngkf.com  
212.372.2153

# NEWMARK

No warranty or representation, express or implied, is made as to the accuracy of the information contained herein, and same is submitted subject to errors omissions, change of price, rental or other conditions, withdrawal without notice, and to any specific listing conditions, imposed by our principals.