

# 30

HUDSON STREET  
JERSEY CITY


## 7TH FLOOR AS-BUILT FLOOR PLAN

### 63,003 RSF

PERIMETER OFFICES	6
INTERIOR OFFICES	22
WORKSTATIONS	480
TOTAL CAPACITY	488

CONFERENCE ROOMS	6
COPY ROOMS	3

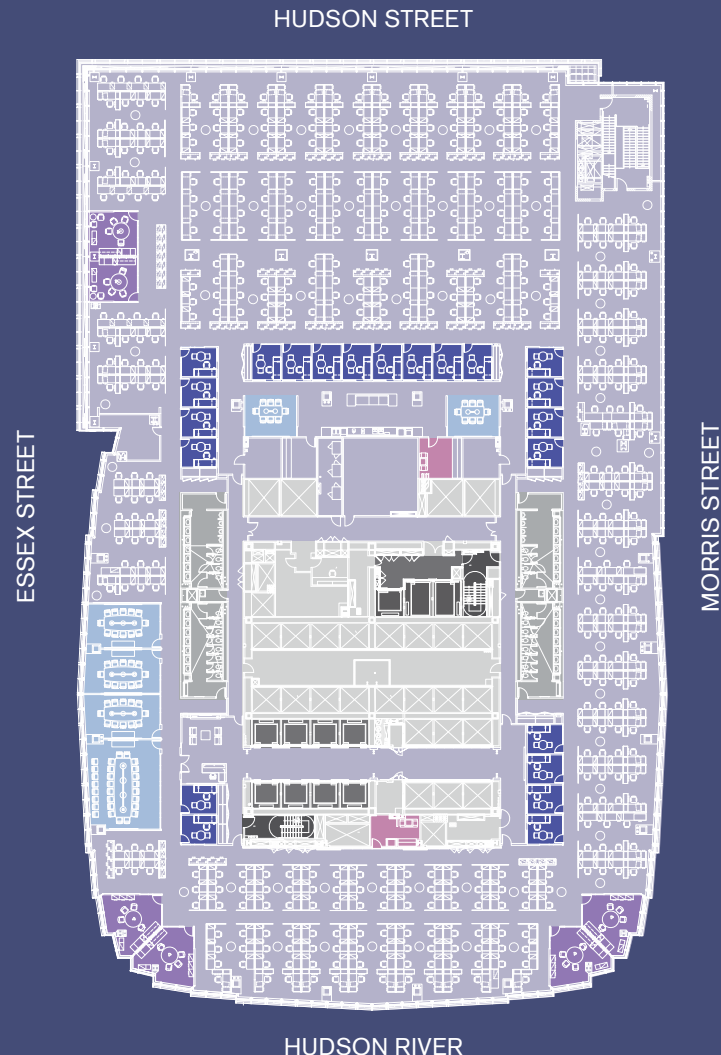

**Hope G. Brodsky**  
Hope.Brodsky@nmrk.com  
201.460.5110

**Harrison Russell**  
Harrison.Russell@nmrk.com  
201.504.5171

**Hal Stein**  
Hal.Stein@nmrk.com  
212.233.8185

**Neil J. Goldmacher**  
Neil.Goldmacher@nmrk.com  
212.372.2153

**NEWMARK**

No warranty or representation, express or implied, is made as to the accuracy of the information contained herein, and same is submitted subject to errors omissions, change of price, rental or other conditions, withdrawal without notice, and to any specific listing conditions, imposed by our principals.