

# 30


HUDSON STREET  
JERSEY CITY

## 9TH FLOOR AS-BUILT FLOOR PLAN

### 36,674 RSF

PERIMETER OFFICES	4
INTERIOR OFFICES	11
WORKSTATIONS	269
TOTAL CAPACITY	284
CONFERENCE ROOMS	5
COPY ROOMS	2

ESSEX STREET

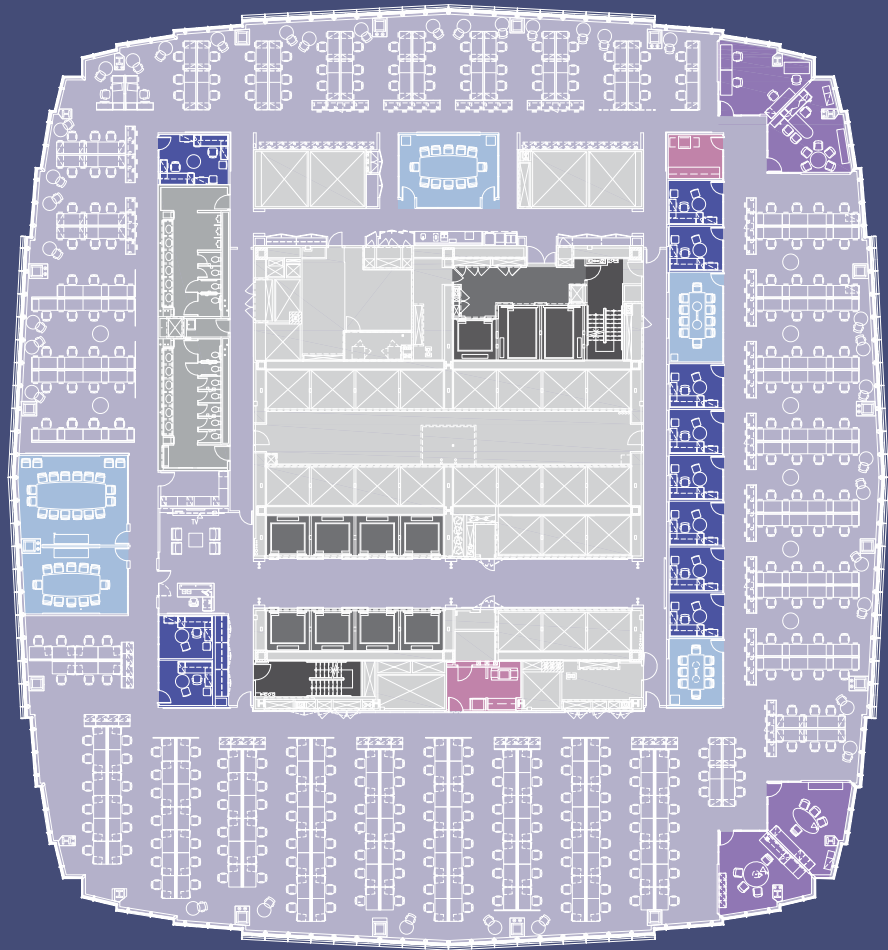

HUDSON STREET

MORRIS STREET

HUDSON RIVER



**Hope G. Brodsky**  
Hope.Brodsky@nrmk.com  
201.460.5110

**Harrison Russell**  
Harrison.Russell@nrmk.com  
201.504.5171

**Hal Stein**  
Hal.Stein@nrmk.com  
212.233.8185

**Neil J. Goldmacher**  
Neil.Goldmacher@nrmk.com  
212.372.2153

# NEWMARK

No warranty or representation, express or implied, is made as to the accuracy of the information contained herein, and same is submitted subject to errors omissions, change of price, rental or other conditions, withdrawal without notice, and to any specific listing conditions, imposed by our principals.