


# 30

HUDSON STREET  
JERSEY CITY

## 10TH FLOOR AS-BUILT FLOORPLAN

### 36,475 RSF

PERIMETER LARGE OFFICES	4
INTERIOR OFFICES	23
WORKSTATIONS	240
<hr/>	
TOTAL CAP	267
<hr/>	
CONFERENCE ROOMS	4
COPY ROOMS	2

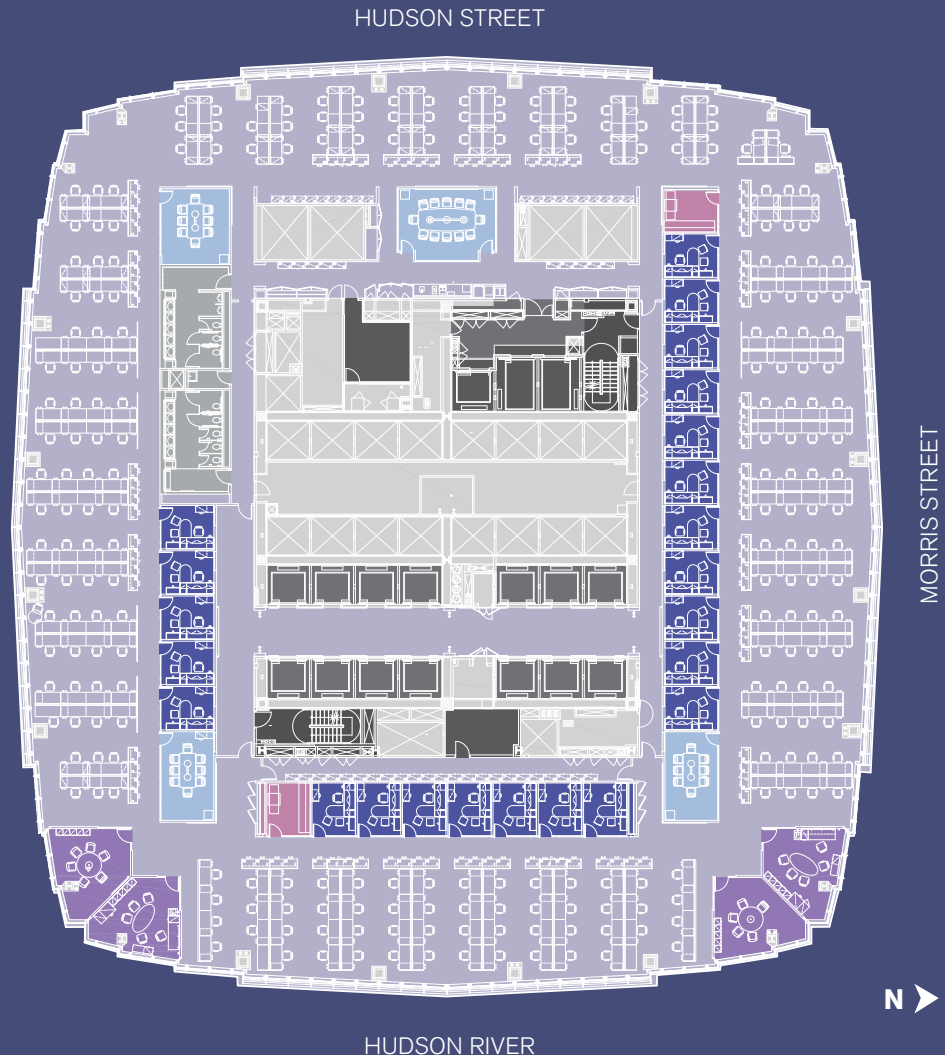

**Hope G. Brodsky**  
hbrodsky@ngkf.com  
201.460.5110

**Harrison Russell**  
hrussell@ngkf.com  
201.504.5171

**Hal Stein**  
hstein@ngkf.com  
212.233.8185

**Neil J. Goldmacher**  
ngoldmacher@ngkf.com  
212.372.2153

# NEWMARK

No warranty or representation, express or implied, is made as to the accuracy of the information contained herein, and same is submitted subject to errors omissions, change of price, rental or other conditions, withdrawal without notice, and to any specific listing conditions, imposed by our principals.