


30

HUDSON STREET
JERSEY CITY

9TH FLOOR AS-BUILT FLOORPLAN

36,476 RSF

PERIMETER OFFICES	4
INTERIOR OFFICES	11
WORKSTATIONS	269
TOTAL CAP	284
<hr/>	
CONFERENCE ROOMS	5
COPY ROOMS	2

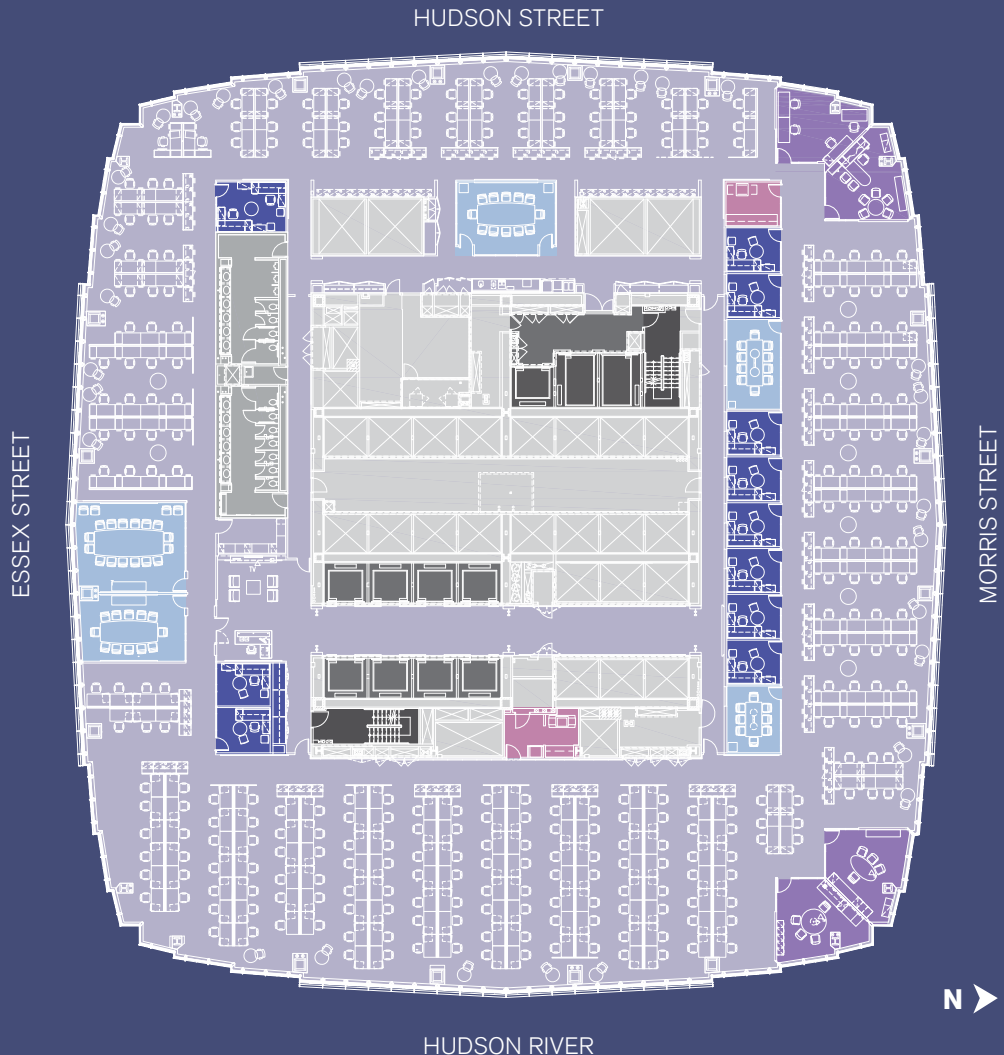

Hope G. Brodsky
hbrodsky@ngkf.com
201.460.5110

Harrison Russell
hrussell@ngkf.com
201.504.5171

Hal Stein
hstein@ngkf.com
212.233.8185

Neil J. Goldmacher
ngoldmacher@ngkf.com
212.372.2153

NEWMARK

No warranty or representation, express or implied, is made as to the accuracy of the information contained herein, and same is submitted subject to errors omissions, change of price, rental or other conditions, withdrawal without notice, and to any specific listing conditions, imposed by our principals.