30 HUDSON STREET
JERSEY CITY

5TH FLOOR
AS-BUILT FLOOR PLAN

63,270 RSF

PERIMETER OFFICES	9
INTERIOR OFFICES	20
WORKSTATIONS	550
TOTAL CAPACITY	579
CONFERENCE ROOMS	6
COPY ROOMS	2

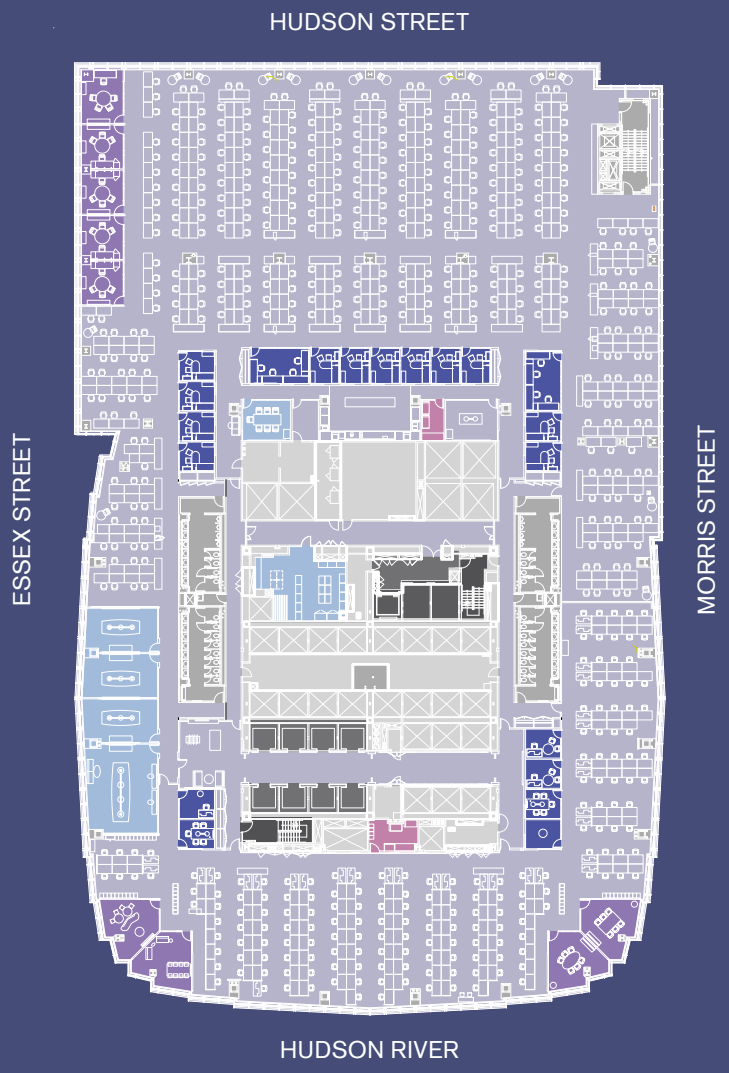

Hope G. Brodsky
Hope.Brodsky@nmrk.com
201.460.5110

Harrison Russell
Harrison.Russell@nmrk.com
201.504.5171

Hal Stein
Hal.Stein@nmrk.com
212.233.8185

Neil J. Goldmacher
Neil.Goldmacher@nmrk.com
212.372.2153

NEWMARK

No warranty or representation, express or implied, is made as to the accuracy of the information contained herein, and same is submitted subject to errors omissions, change of price, rental or other conditions, withdrawal without notice, and to any specific listing conditions, imposed by our principals.